



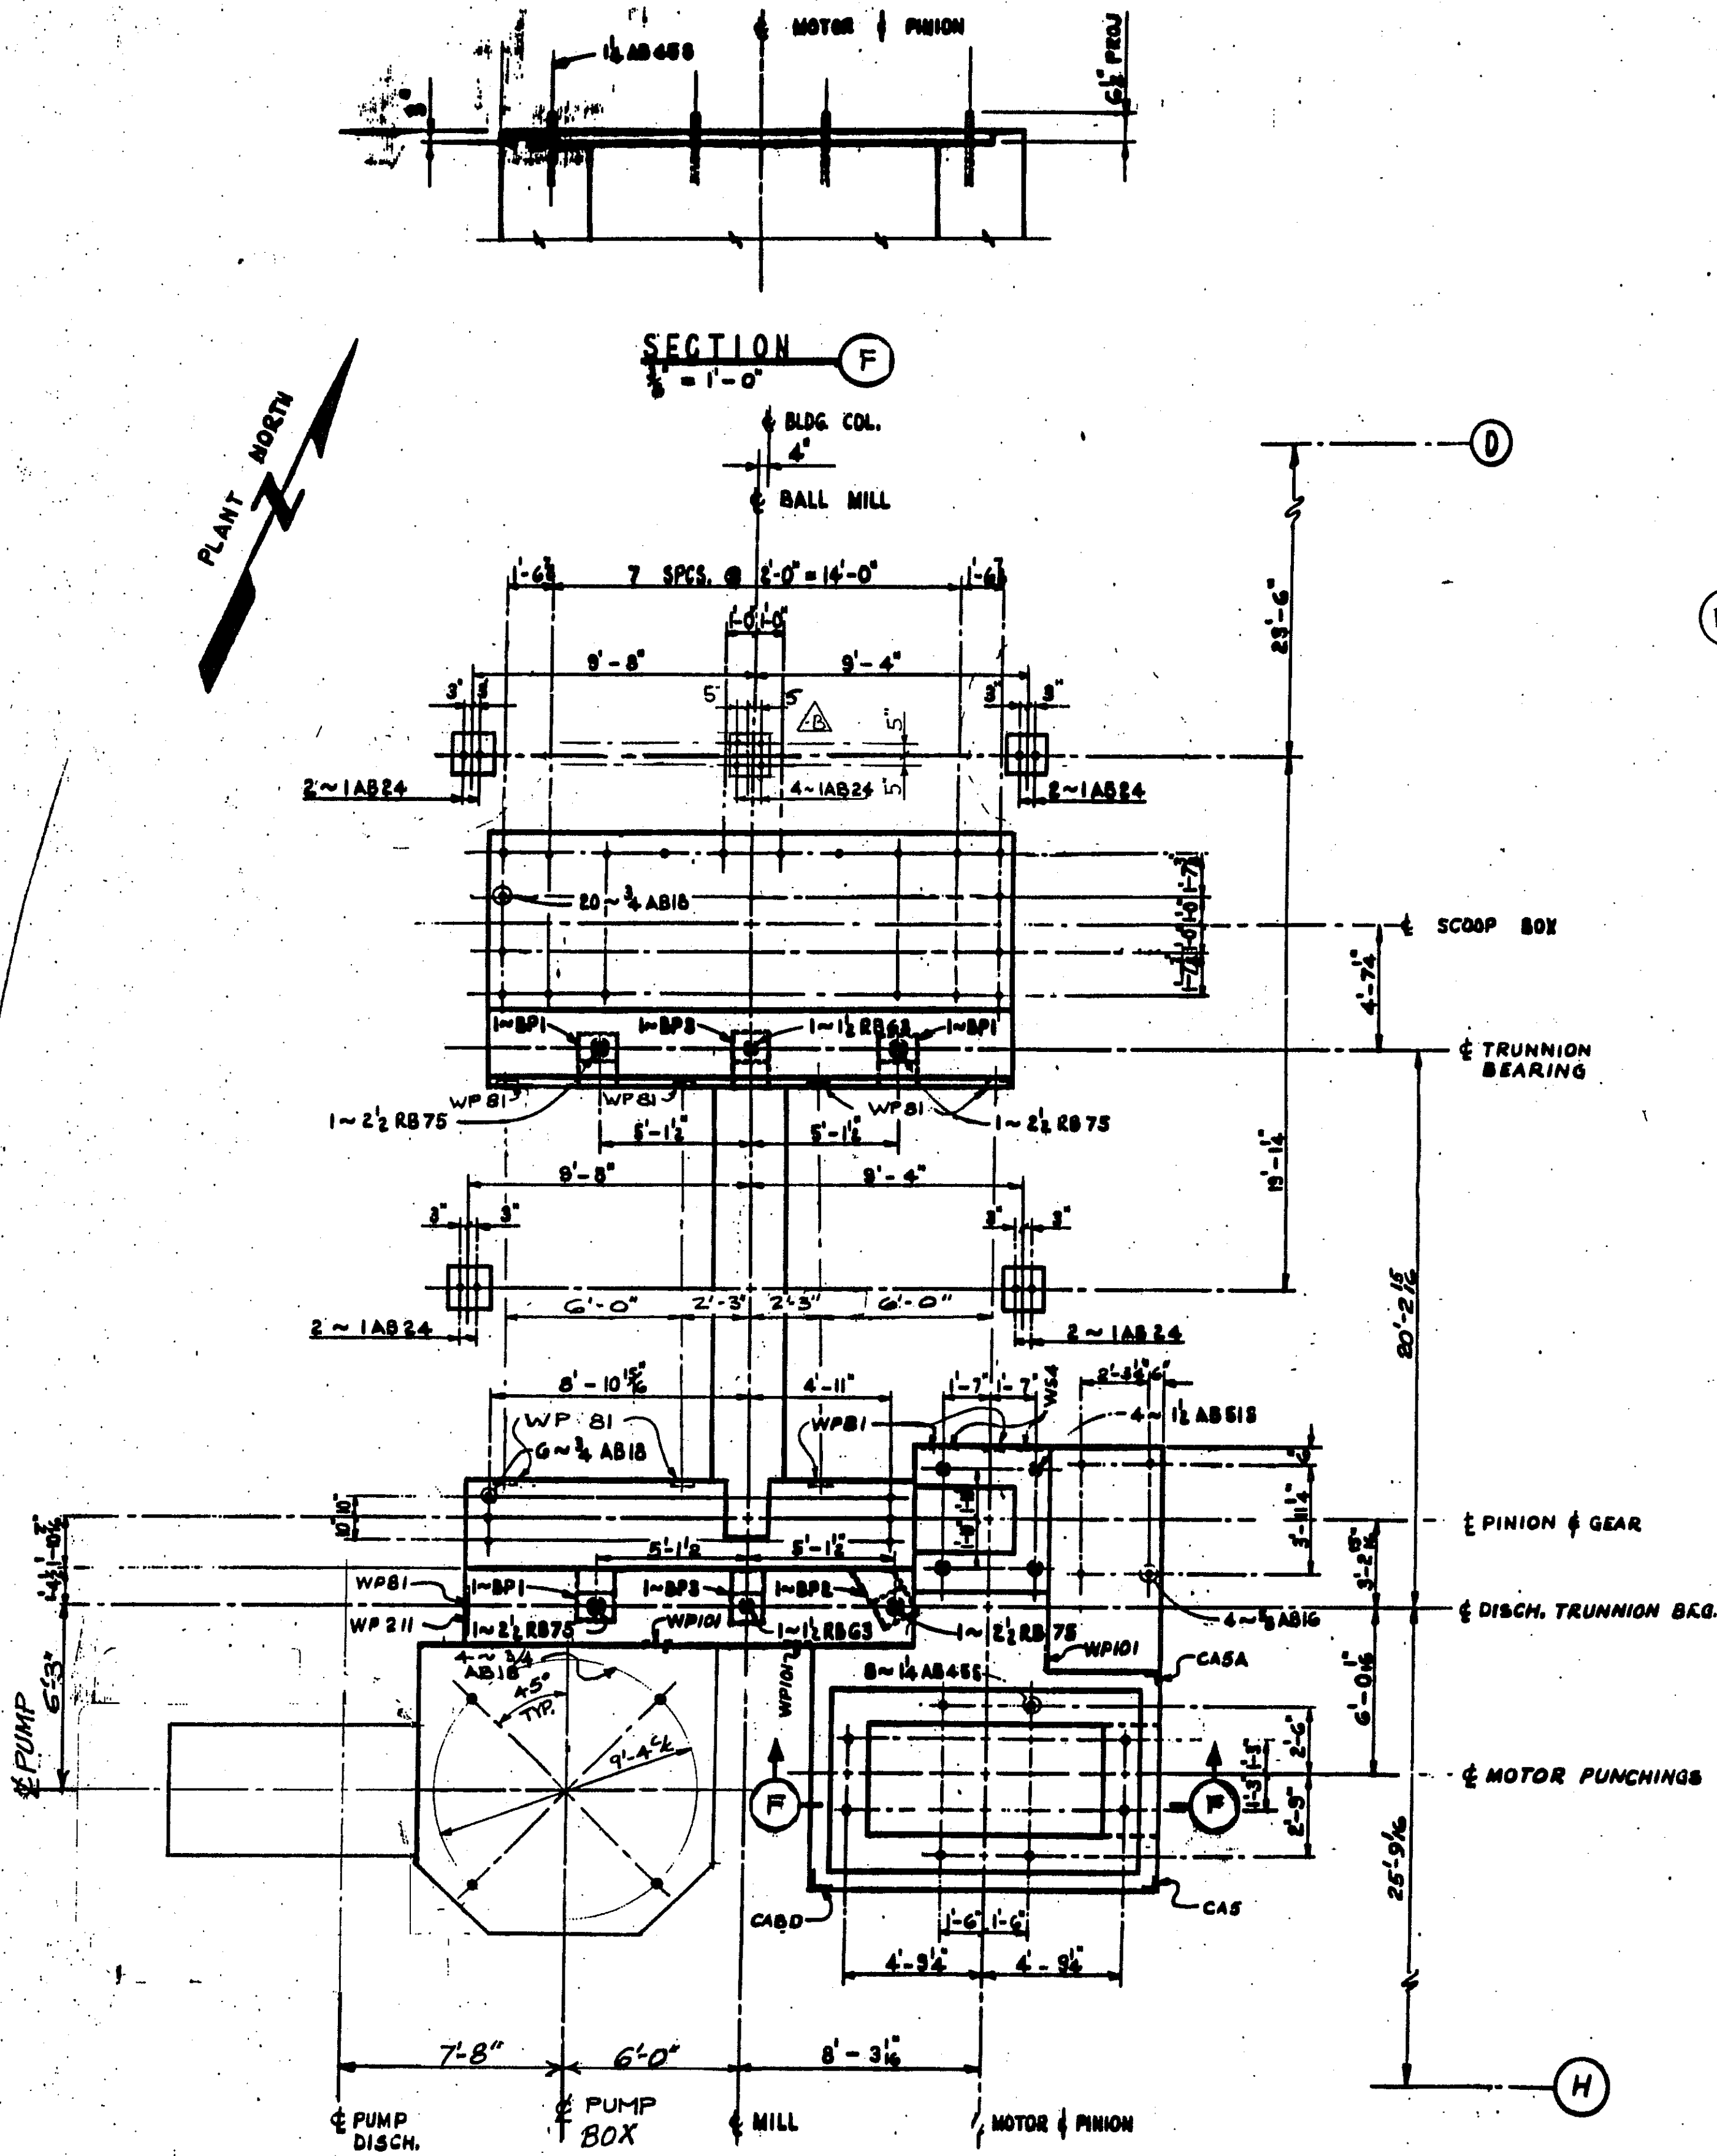

ANCHOR BOLT PLAN
FOR MILL C2, 4 C3

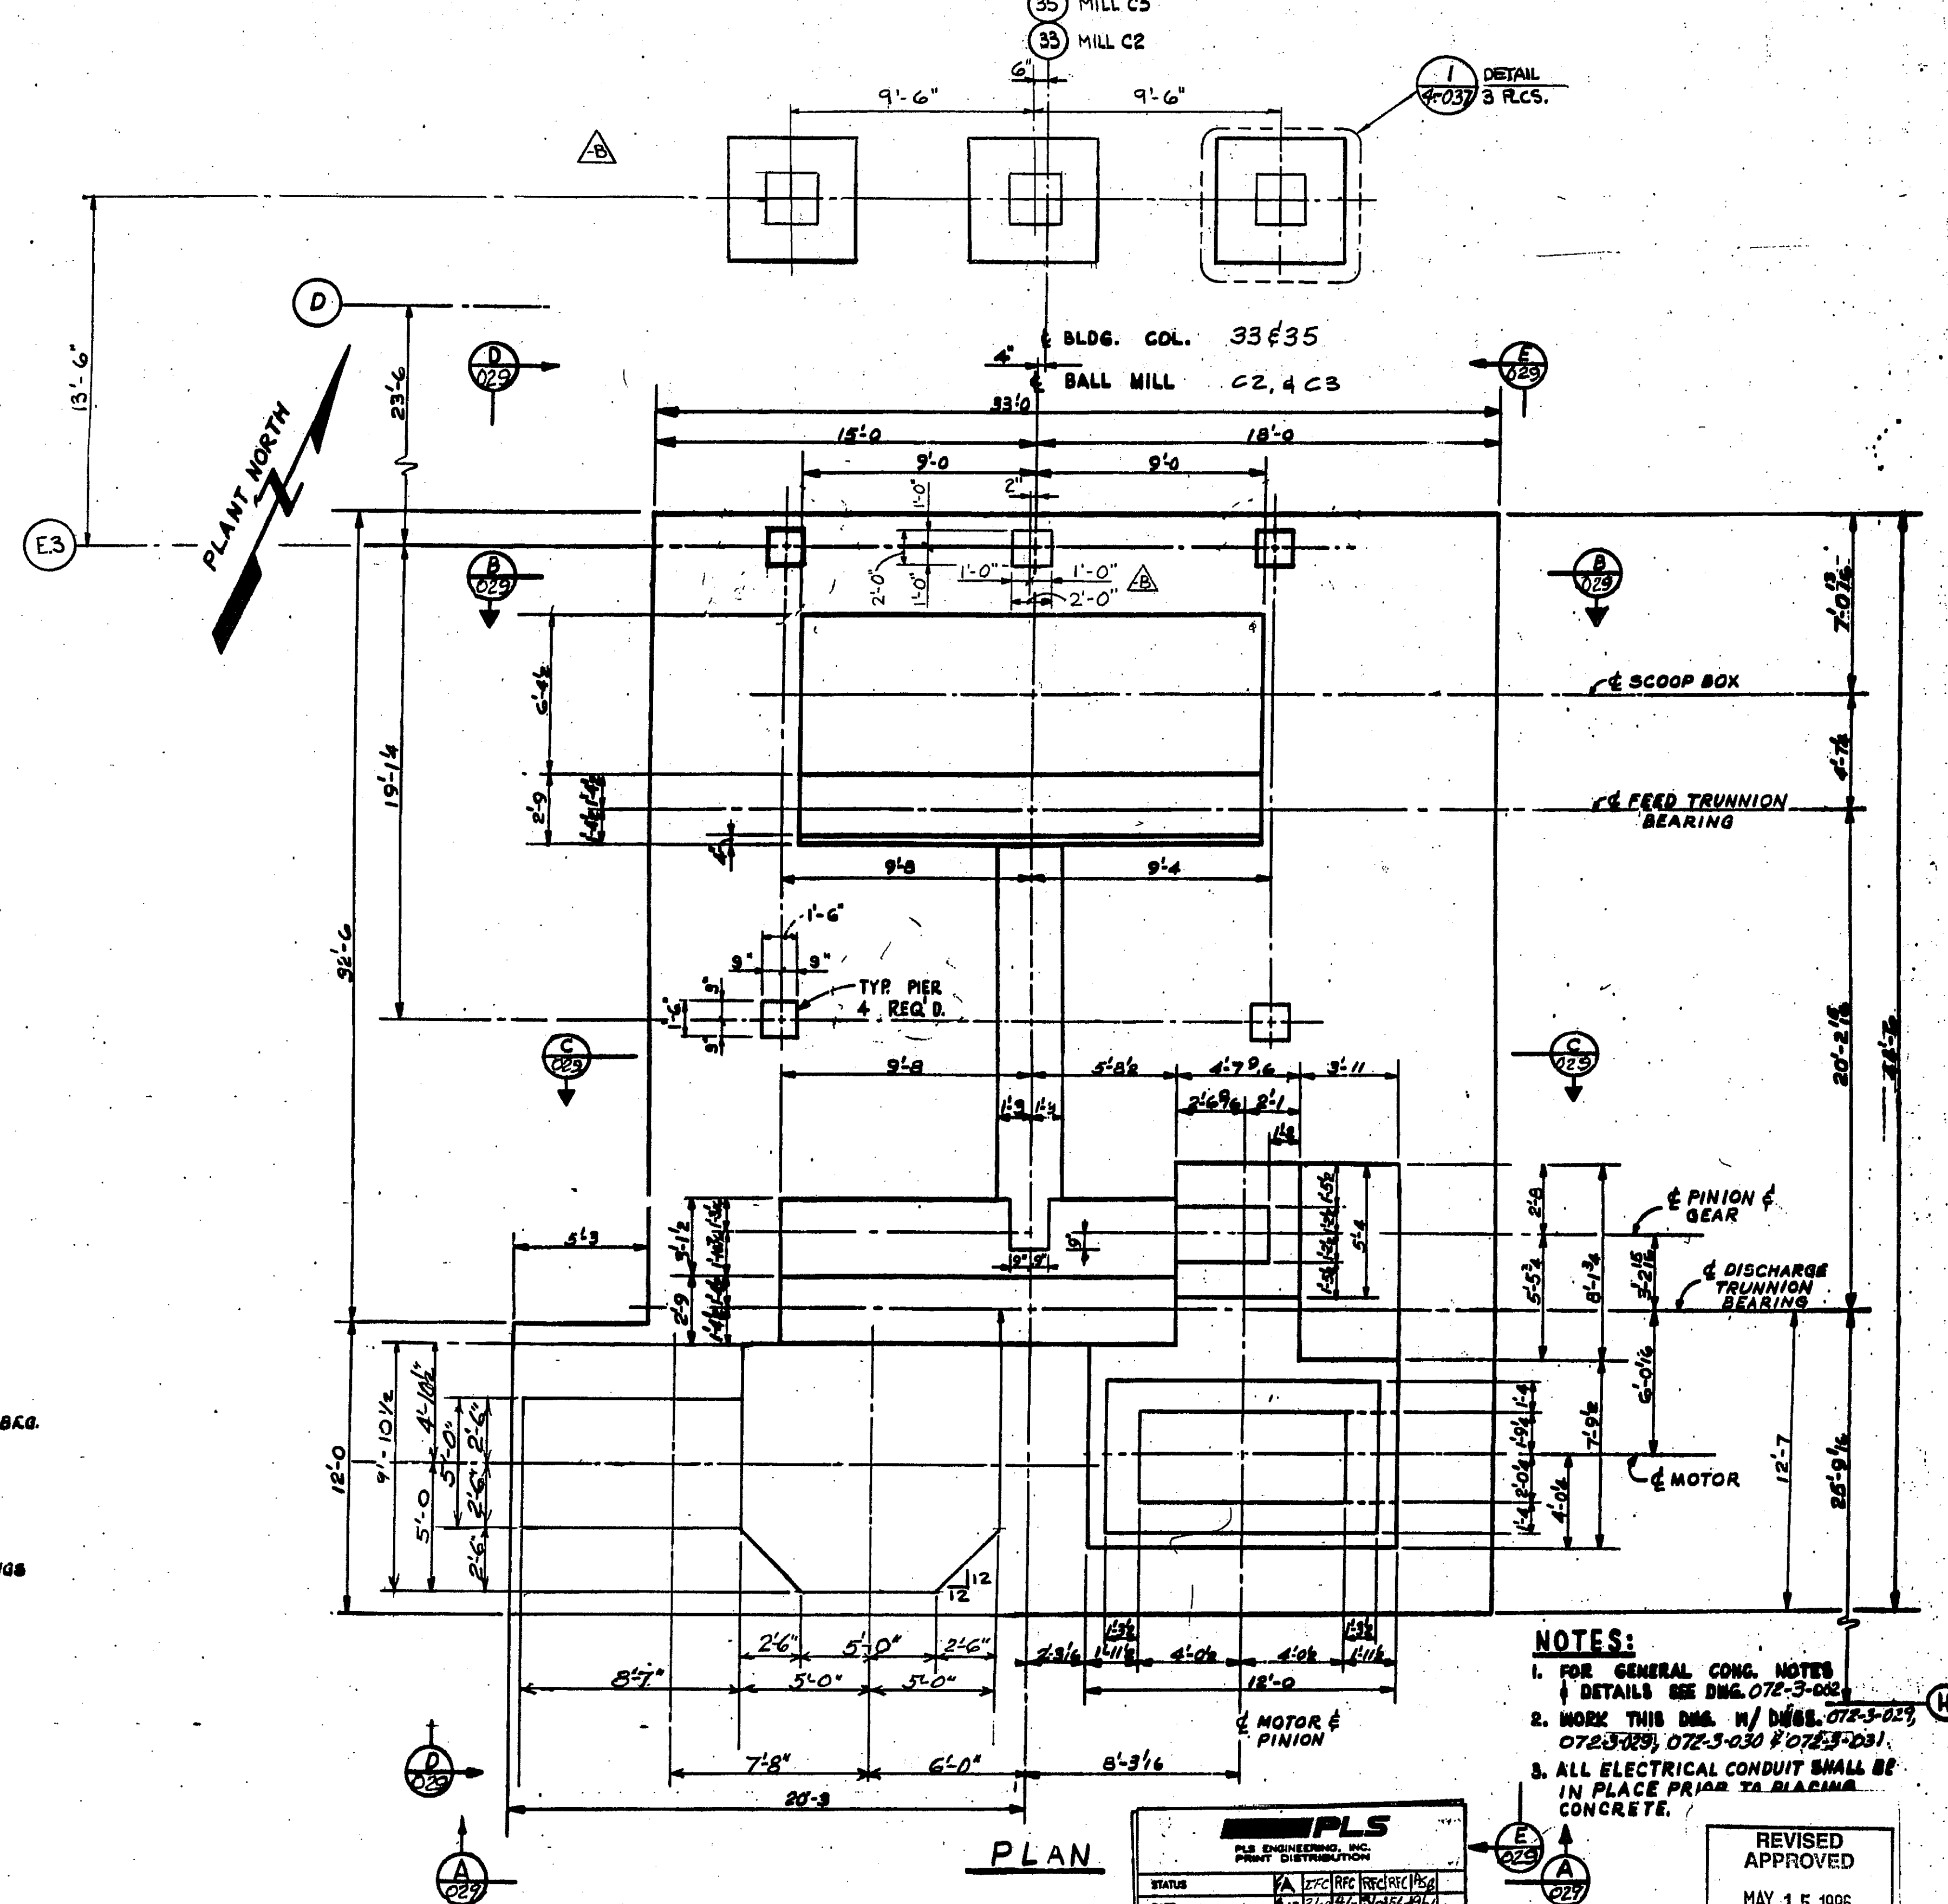

PLAN

NOTES:

1. FOR GENERAL CONC. NOTES & DETAILS SEE DWG. 072-3-002
2. WORK THIS DWG. W/ DWG. 072-3-023, 072-3-029, 072-3-030 & 072-3-031
3. ALL ELECTRICAL CONDUIT SHALL BE IN PLACE PRIOR TO PLACING CONCRETE.

PLS ENGINEERING, INC.	
STATUS	APPROVED
DATE	4/13/96
REV. NO.	1
PROJECT MANAGER P.D.	2 5 5 6 12
CONSTR. MANAGER P.D.	1 1 1 1 1 1
ENGINEERING P.D.	1 3 3 3 12 12
PLS FIELD	1 7 1 2 12 1
PLS HOME OFFICE	1 1 1 1 1 1

REVISED
APPROVED
MAY 15 1996
FOR
CONSTRUCTION

PLS ENGINEERING, INC.
PLS

REFERENCES		REVISIONS		REVISIONS	
NO.	FILE	NO.	DATE	NO.	DATE
				ARM	2-12-76 ISSUED FOR APPROVAL
				ARM	3-18-76 ISSUED FOR CONSTRUCTION
				ARM	4-1-76 DELETED ANCHOR BOLTS AT PUMP BASE
				ARM	5-8-76 REVISED APPROVED FOR CONSTRUCTION
				ARM	5-15-76 REVISED APPROVED FOR CONSTRUCTION
				ARM	4-24-76 ISSUED AS BUILT

REVISIONS		
NO.	DATE	DESCRIPTION
1	4/13/96	ISSUED FOR APPROVAL
2	4/13/96	ISSUED FOR CONSTRUCTION
3	4/13/96	DELETED ANCHOR BOLTS AT PUMP BASE
4	4/13/96	REVISED APPROVED FOR CONSTRUCTION
5	4/13/96	REVISED APPROVED FOR CONSTRUCTION
6	4/13/96	ISSUED AS BUILT

SCALE	1"=1'-0"
DATE	2-9-96
BY	RM
CHECKED BY	NP/PCS
DATE	2-13-16/96



METCALF CONCENTRATOR	
GRINDING & CLASSIFYING	
CONCRETE	
12' x 14' BALL MILL FNDN.	
PLAN & OUTLINE SH. 1	
BALL MILLS C2, 4 C3	