




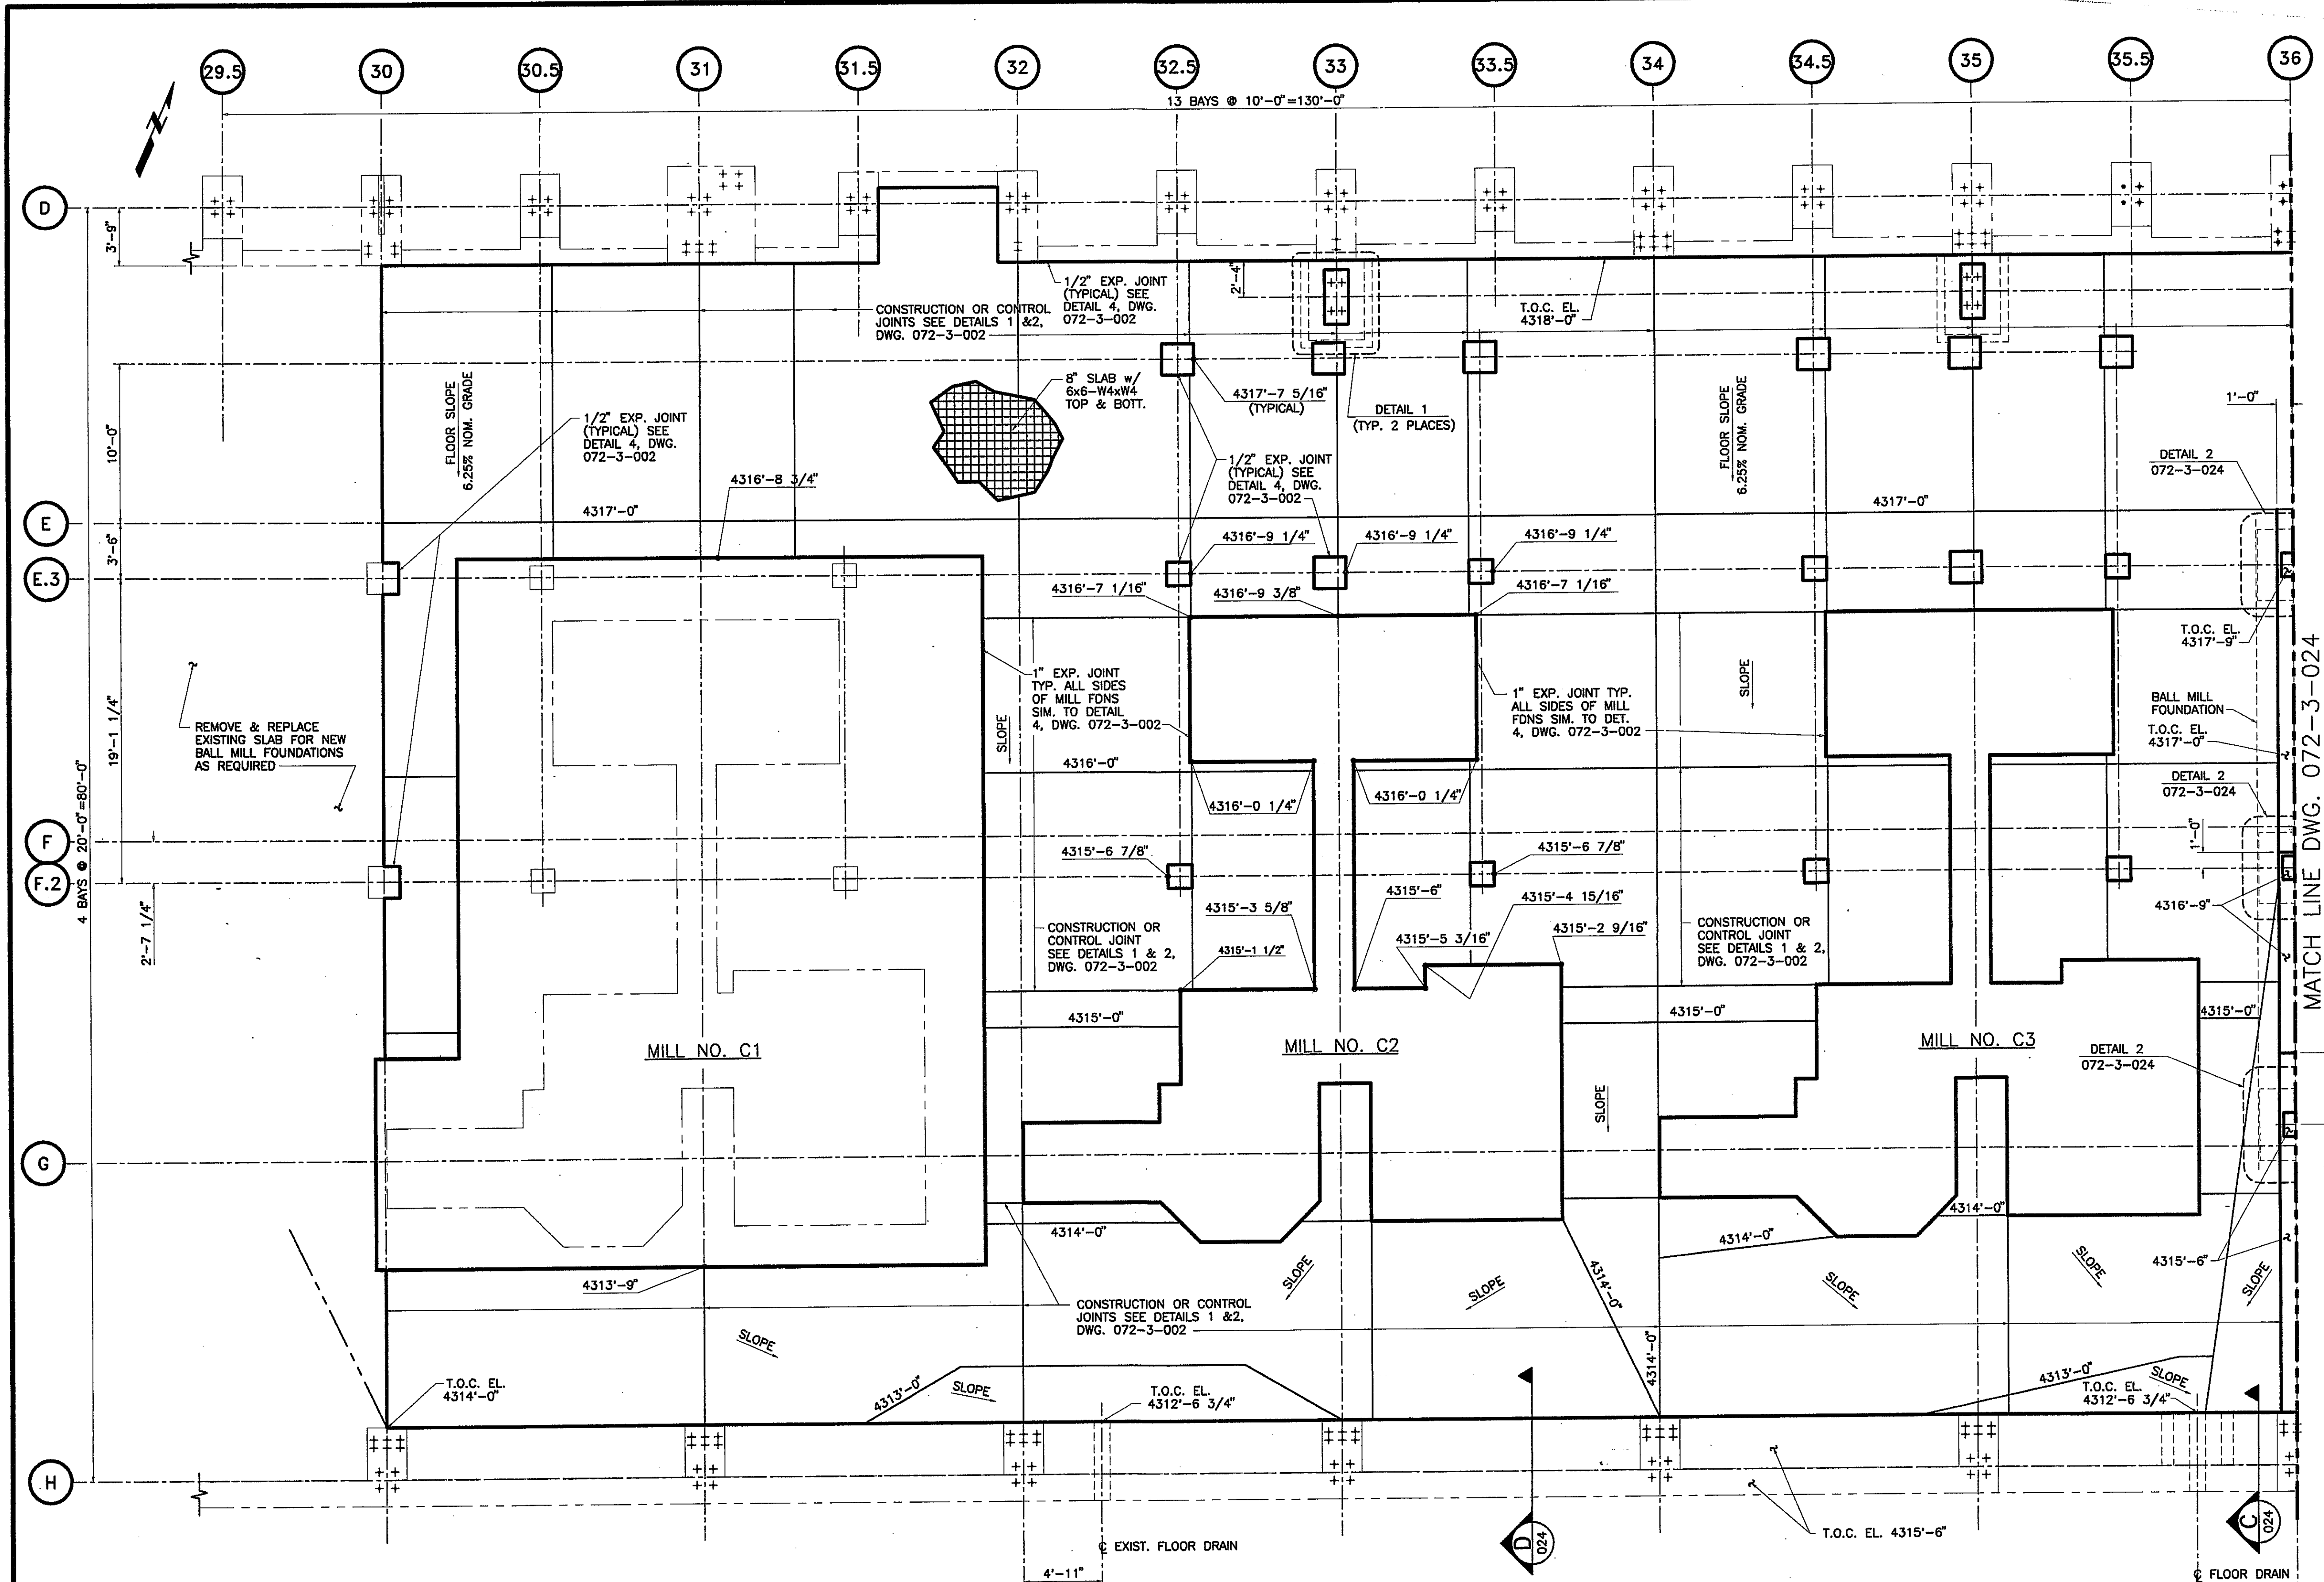


PLAN
SCALE: 3/16"=1'-0"

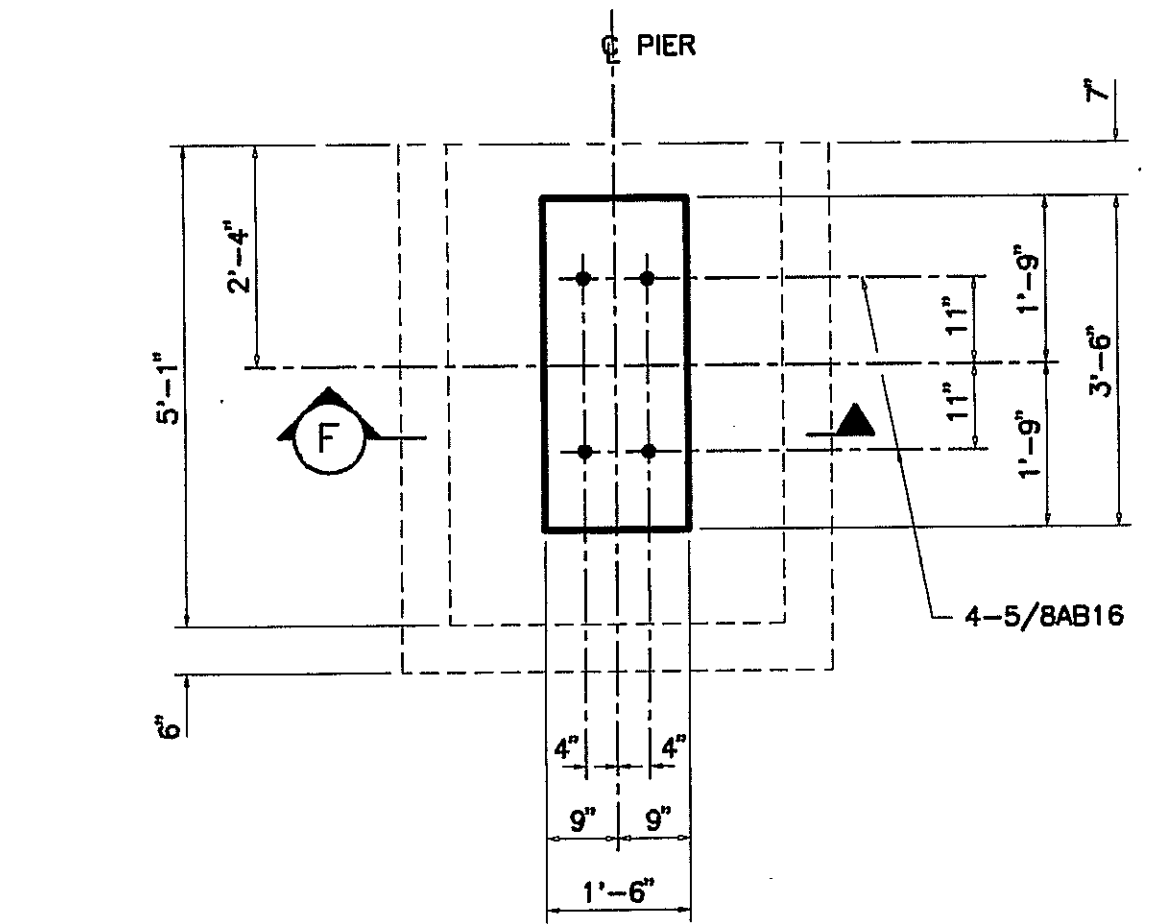

DETAIL 1
072-3-023, -024 SCALE: 1/2"=1'-0"

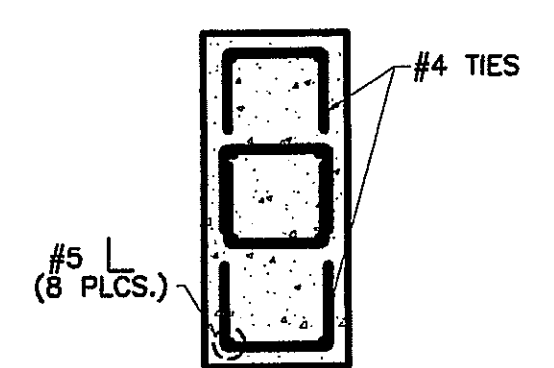


SECTION G
SCALE: 1/2"=1'-0"

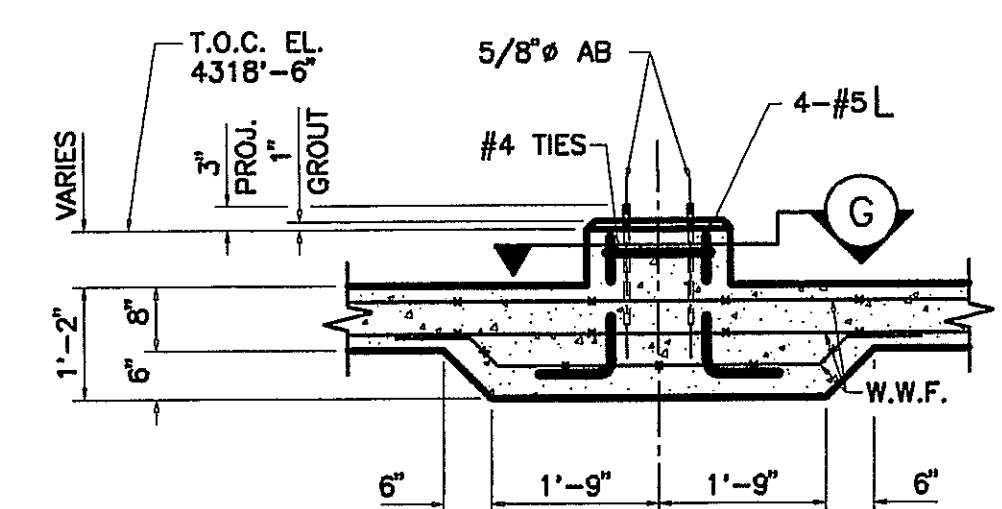

SECTION F
SCALE: 1/2"=1'-0"

- NOTES:
1. FOR GENERAL CONCRETE NOTES SEE DWG. 072-3-002
 2. WORK THIS DRAWING WITH DRAWING 072-3-024.
 3. SPOT ELEV'S. SHOWN @ MILL NO. C2 ARE TYPICAL FOR MILL NO. C3.
 4. ELEVATIONS SHOWN ARE TOP OF CONCRETE U.N.O.

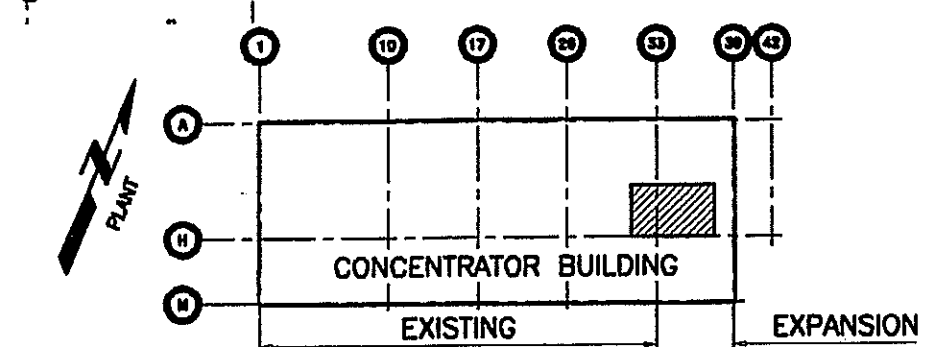

KEY PLAN
SCALE 1"=300'

PLS	
PLS ENGINEERING, INC. PRINT DISTRIBUTION	
STATUS	FA IFCASE
DATE	6/15/2010/31
REV. NO.	2
PROJECT MANAGER P D	2 6
CONSTR. MANAGER P D	2 3
ENGINEERING P D	2 3
PLS FIELD	2 2
PLS HOME OFFICE	1 1

PLS ENGINEERING, INC.
PLS

REFERENCES		REFERENCES		REVISIONS		REVISIONS		NOTES		SCALE		SHEET SIZE		DIVISION		PROJECT		JOB NO.	
DWG. NO.	TITLE	DWG. NO.	TITLE	NO.	BY	DATE	DESCRIPTION	NO.	BY	DATE	DESCRIPTION	NOTED	D	AREA	DESCRIPTION	DWG. NO.	REVISION	DATE	BY
072-3-024	GROUND FLOOR SLAB COL. D-H & 36-39			1	DBL	6/15/96	ISSUED FOR APPROVAL							GRINDING & CLASSIFYING		072-3-023		5/18/96	J-95024
				2	DBL	6/20/96	ISSUED FOR CONSTRUCTION							METCALF 'C' EXPANSION		0723023B			
				3	GCB	10/31/96	ISSUED PER AS BUILT							CONCRETE					
														GROUND FLOOR SLAB					
														COL. D-H & 29.5-36					